

CHANGE ORDER

DATE OF ISSUANCE 1/28/2019 EFFECTIVE DATE 1/28/2019 No. 2

PROJECT: 2018 Water System Improvements

OWNER City of Oregon City

CONTRACTOR Trench Line Excavation, Inc

Contract: CI 18-006

OWNER's Contract No. CI 18-006

ENGINEER's Project No. 1448A

ENGINEER Wes Wegner (Wallis Engineering)

The following includes details for change orders 2.

Change Order 2 – Fire Line to 824 Center Street

You are directed to make the following changes in the Contract Documents.

Description: Furnish and install all materials, equipment and labor necessary to construct a new fire line to 824 Center Street as detailed on the revised sheet C7 dated 1/25/2019.

Temporary and permanent restorations as well as rock excavation will be paid for under existing bid items.

Reason for Change Order: During installation of the waterline on 9th Street, an existing unknown fire line to 824 Center Street was discovered. The City determined that this fire line needed to be reconnected as part of this project to ensure the continuing functionality of any fire systems inside the building.

Change in Contract Price: Work under Change Order 2 will be paid at the Lump Sum price of \$5,982.00.

Change in Contract Times: No change in Contract Time was requested by the Contractor.

CHANGE IN CONTRACT PRICE:	CHANGE IN CONTRACT TIMES:
Original Contract Price: \$884,750.00	Original Contract Times: Substantial Completion: NA Ready for final payment: 85 Calendar Days <small>(days or dates)</small>
Net Increase from previous Change Orders No. 0 to No. 1: \$5,179.00	Net change from previous Change Orders No. 0 to No. 1: Substantial Completion: 0 Ready for final payment: 0 <small>(days)</small>
Contract Price prior to the Change Order: \$889,929.00	Contract Times prior to this Change Order: Substantial Completion: NA Ready for final payment: 85 Calendar Days <small>(days or dates)</small>
Net Increase (Decrease) of the Change Order: \$5,982.00	Net Increase (Decrease) of this Change Order: Substantial Completion: NA Ready for final payment: 0 Calendar Days <small>(days)</small>
Contract Price with all approved Change Orders: \$ 895,911.00	Contract Times with all approved Change Orders: Substantial Completion: NA Ready for final payment: 85 Calendar Days <small>(days or dates)</small>

RECOMMENDED:

By: [Signature]
ENGINEER (Authorized Signature)

Date: 1/28/2019

APPROVED:

By: [Signature]
OWNER (Authorized Signature)

Date: 1/31/19

ACCEPTED:

By: [Signature]
CONTRACTOR (Authorized Signature)

Date: 1/28/19


EJCDC No. 1910-8-B (1996 Edition)

Prepared by the Engineers Joint Contract Documents Committee and endorsed by The Associated General Contractors of America and the Construction Specifications Institute.

SEE SHEET C5 FOR CONTINUATION

SEE SHEET C5 FOR CONTINUATION

PLAN

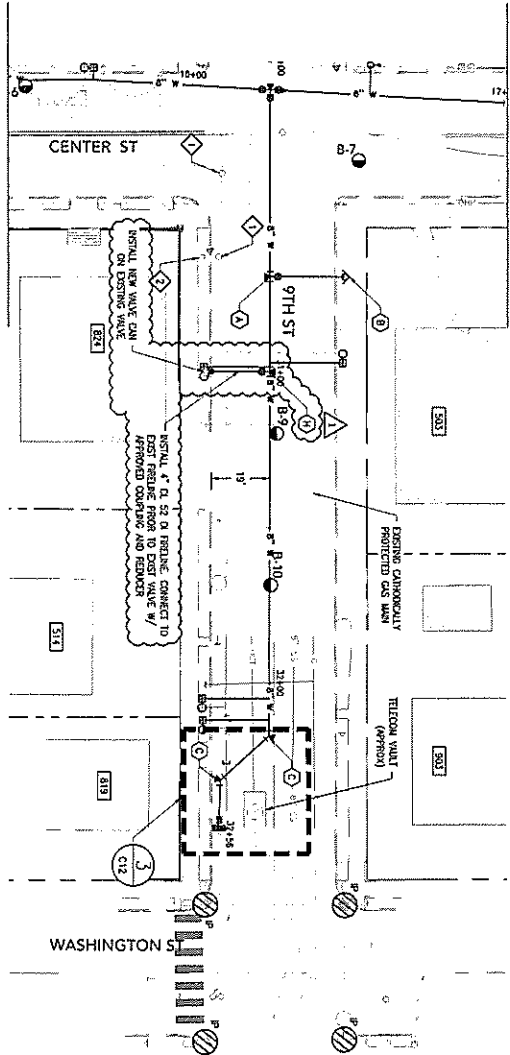

WATER SERVICE SCHEDULE

STATION	ADDRESS	USE	SIZE	METER SIZE
30+97	503	1	5/8" X 3/4"	1/2" MTR
30+98	524	2	5/8" X 3/4"	1/2" MTR
32+05	514	1	5/8" X 3/4"	1/2" MTR
32+12	519	1	5/8" X 3/4"	1/2" MTR

CONSTRUCTION NOTES



- WHERE BODIES ARE NOT SHOWN, DETECT JOINTS A WARNING OF THE WATERWORKS' RECOMMENDATION TO ACHIEVE THE ASSEMBLY AND PROFILE SHOWN.
- VALVE ABANDONMENT SHALL CONSIST OF REMOVING VALVE STEEL, CAPPING AND REMOVING MFL, REMOVING VALVE BOX, AND BACKFILLING.
- PROTECT EXISTING CURB AND SIDEWALK WHERE POSSIBLE. CONSIDER REMOVAL WITH INSPECTION PRIOR TO REMOVAL.
- EXISTING WATER MAIN IN 9TH STREET SHALL BE ABANDONED IN PLACE. EXPOSED ENDS SHALL BE CAPPED OR GROUT FULGID.
- SEE GEOTECHNICAL REPORT FOR ADDITIONAL INFORMATION ON BODILY INVESTIGATIONS.

VALVE & FITTING SCHEDULE

- INSTALL (TYPE 1)
1 - 8" X 6" FL X 1/2" TE W/ THURST BLOCK
1 - 6" FL X 1/2" TE
- INSTALL (TYPE 1)
1 - 8" X 6" FL X 1/2" TE W/ THURST BLOCK
1 - 6" FL X 1/2" TE
- INSTALL (TYPE 2)
1 - 8" X 6" FL X 1/2" TE W/ THURST BLOCK

ABANDONMENT SCHEDULE

- ABANDON (TYPE 1)
1 - 8" X 6" FL X 1/2" TE W/ THURST BLOCK
1 - 6" FL X 1/2" TE
- ABANDON (TYPE 2)
1 - 8" X 6" FL X 1/2" TE W/ THURST BLOCK

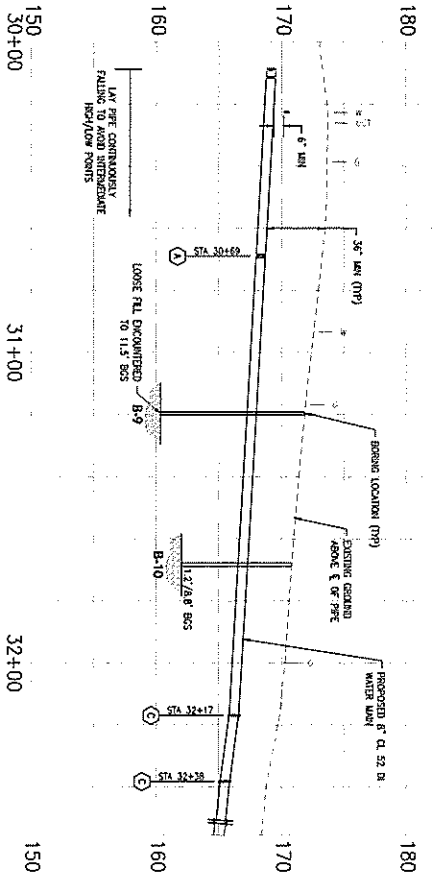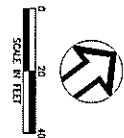

PROFILE
SCALE 1" = 2' HORIZ
1" = 5' VERT

Wes Wegner

From: Derek Bennett <trenchlinederek@gmail.com>
Sent: Friday, January 25, 2019 3:59 PM
To: Wes Wegner; "Chris (Pipe Ninja) Stoddard"
Cc: jburrell@orcify.org
Subject: RE: 824 Center Street - Fireline Revision

\$5,982.00 to install as described below.

Resurfacing to be paid per bid item.

Rock ex to be paid per Chris' measurements. Profile view in new drawing still shows rock below pipe zone. (Probably not the case)

Thank you,
-Derek

Derek Bennett
Trench Line Excavation, Inc.
Estimator / Project Manager
Ph: 541-752-0481
Fax: 541-752-5523
Cell: 541-609-6111
trenchlinederek@gmail.com

From: Wes Wegner [<mailto:wes.wegner@walliseng.net>]
Sent: Friday, January 25, 2019 3:08 PM
To: 'Chris (Pipe Ninja) Stoddard' (trenchlinechris@gmail.com) <trenchlinechris@gmail.com>
Cc: jburrell@orcify.org; Derek Bennett (trenchlinederek@gmail.com) <trenchlinederek@gmail.com>
Subject: 824 Center Street - Fireline Revision

Chris,

Following up regarding the fire line encountered on 9th Street serving 824 Center Street. Attached is a revision to sheet C7 that shows what the City would like to do to re-establish this connection. This sketch is the same as what we discussed in the field. Let me know if you see any issues with this approach or if you had something else in mind.

The City is still trying to track down the owner of the building to get inside and see if this sheds any light on their system. It is also unknown if there is a Double Check on this fire line inside the building, and there is a chance that the City will want to install a new DCVA in a vault on 9th if they can't find an existing device. More to come on this issue and we will have to deal with it separately depending on when that information becomes available.

Please provide a lump sum cost to complete the revision as attached including all labor, materials and equipment necessary to complete the work with the exception of temporary and permanent restoration of the road, curb and sidewalk. I propose to use existing bid items for that work if you agree. Let me know if you have any questions,